

**REVISED NOTICE OF PUBLIC HEARING
OF APPLICATION FOR MINOR VARIANCE FROM BY-LAW
(The Planning Act, R.S.O. 1990, Section 45)**

TAKE NOTICE that an application has been made by Francine Sabourin, agent - Lianne MacDonald & Luc Sabourin, for a minor variance from the provisions of Zoning By-Law 38-09 of the Township of South Glengarry, as amended, (being a by-law respecting the use of land and the use and location of buildings) for the property that is legally described as Part of Lot 6, Concession 1 and Lot 53 on Registered Plan 133, being Part 1 on Reference Plan 14R 3353, in the Geographic Township of Lancaster, now in the Township of South Glengarry, County of Glengarry, located at 6274 164th Ave for the following reasons:

THE PURPOSE AND EFFECT OF THE APPLICATION:

The applicant has constructed a dock that does not comply with section 3.39 (7) (G) of Zoning By-Law 38-09. This section requires a dock to be located no closer than 4 meters (13ft.) to the nearest adjacent lot line.

The following relief from the Zoning By-law 38-09 is requested:

To reduce the setback from the east adjacent lot line from 4 meters to 1.8 meters to the existing dock and to reduce the setback from the west adjacent lot line from 4 meters to 0 meters to the existing dock. (see attached sketch).

ADDITIONAL INFORMATION relating to the application is available for inspection during office hours at the Township of South Glengarry Office, located at 6 Oak Street, Lancaster, ON.

FURTHER TAKE NOTICE that the Committee of Adjustment will hold a public meeting on **Monday, March 9th, 2026 at 5:30 pm** for the purpose of a public hearing into this matter, to be held in the Council Chambers located at the Tartan Hall, Char Lan Recreation Centre, 19740 John Street, Williamstown.

FURTHER TAKE NOTICE that the subject is not the subject of an application under the Planning Act.

THIS NOTICE IS SENT TO YOU BECAUSE YOU ARE AN ASSESSED OWNER OF LAND NEAR THE SUBJECT PROPERTY, OR AN INTERESTED PARTY. YOU ARE NOT COMPELLED TO ATTEND, HOWEVER, THE APPLICANT OR THEIR AGENT MUST BE PRESENT AT THE HEARING.

You are entitled to attend this public hearing in-person or you may be represented by counsel or an agent to give evidence about this application. Signed, written submissions that relate to an application shall be accepted by the Secretary-Treasurer before or during the hearing of the application at the addresses above and shall be available to any interested person for inspection at the hearing. Statutory Powers Procedure Act, R.S.O. 1990.

IF A PROPERTY CONTAINS SEVEN OR MORE RESIDENTIAL UNITS, the owner is required to post this notice at a location that is visible to all of the residents. O. Reg. 175/16, s. 1 (8-10)

NOTICE OF DECISION

A certified copy of the decision, together with a notice of the last day for appealing to the Ontario Land Tribunal shall be sent, not later than 10 days from the making of the decision, to the applicant, and to each person who appeared in person or by counsel at the hearing and who filed with the Secretary-Treasurer a written request for notice of the decision. Planning Act, R.S.O. 1990, c.P.13, s. 45 (10)

FAILURE TO ATTEND HEARING If you do not attend this public hearing, it may proceed in your absence and, except as otherwise provided in the Planning Act, you will not be entitled to any further notice in the proceedings. Statutory Powers Procedure Act, R.S.O. 1990, c.S.22, s 7.

Dated: February 26, 2026

Joshua Hutten
Secretary-Treasurer
Committee of Adjustment
Township of South Glengarry
613-347-1166 ext. 2207
jhutten@southglengarry.com


Key Map



Revised Jan 27, 2026.



LOT 53
REGISTRAR'S COMPILED PLAN NO. 133
BEING PART OF LOT 6
CONCESSION 1
TOWNSHIP OF LANCASTER
COUNTY OF GLENBARRY

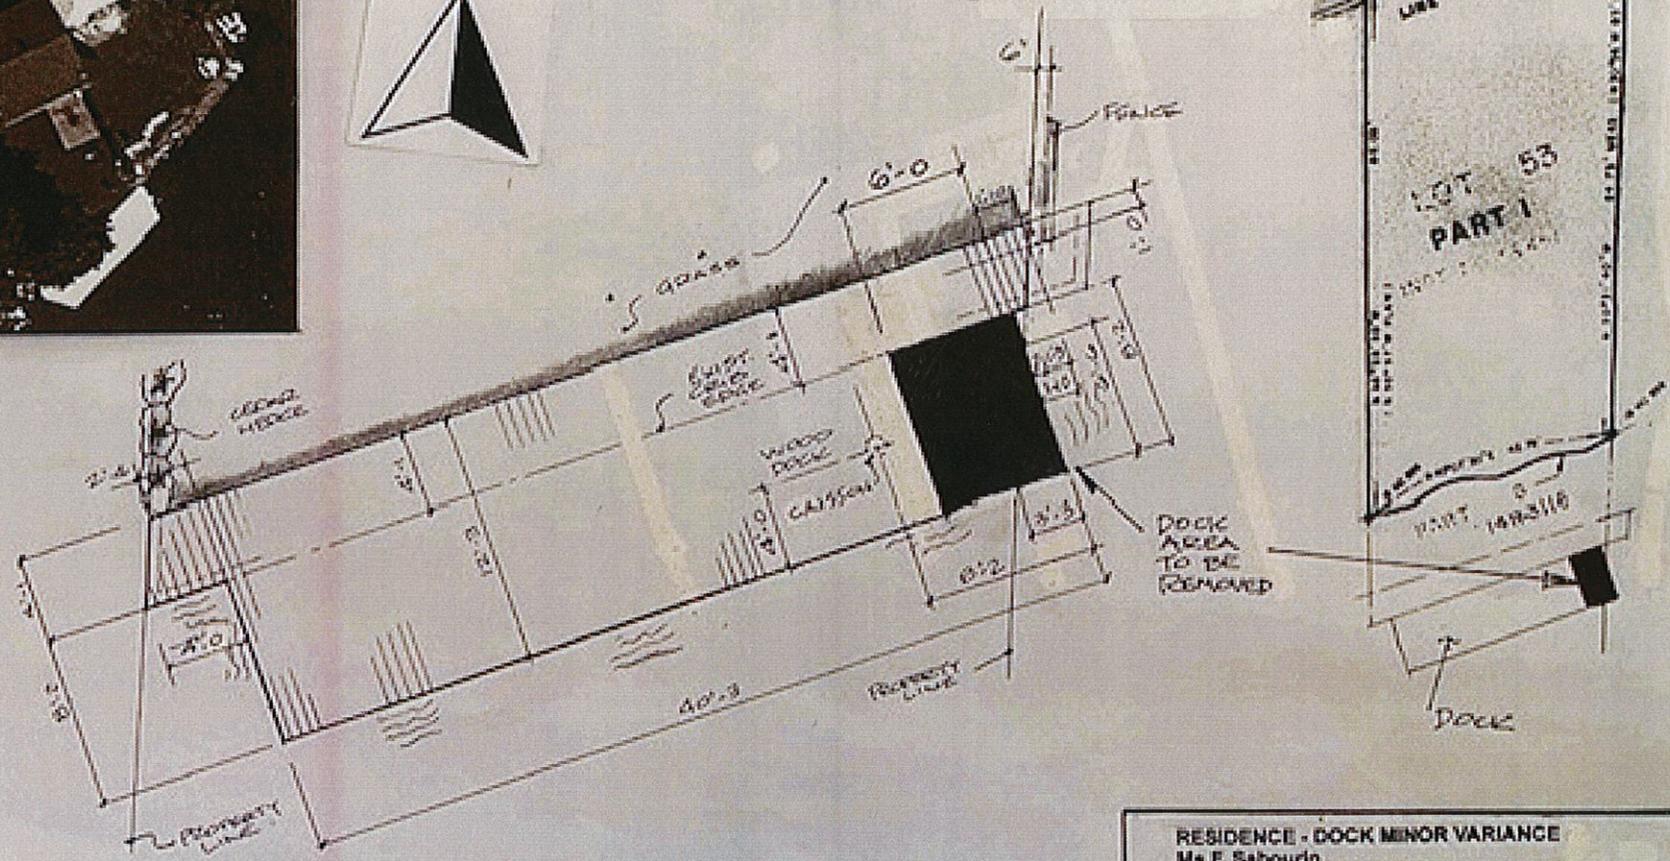

RESIDENCE - DOCK MINOR VARIANCE	
Ms F. Sabourin	
8274 184th Ave	
Bainville, ON	
PLAN - OPTION TWO	
DATE: DEC 2025	SCALE: 1/4"=1'-0"
DRAWN BY:	DWG 1 OF 1